THE INFORMATION CONTAINED HEREIN IS THE CONFIDENTIAL PROPERTY OF TOROMONT PROCESS SYSTEMS AND IS NOT FOR PUBLICATION, AND NO PART THEREOF SHALL BE COPIED OR COMMUNICATED TO A THIRD PARTY WITHOUT AUTHORIZATION FROM TOROMONT PROCESS SYSTEMS.

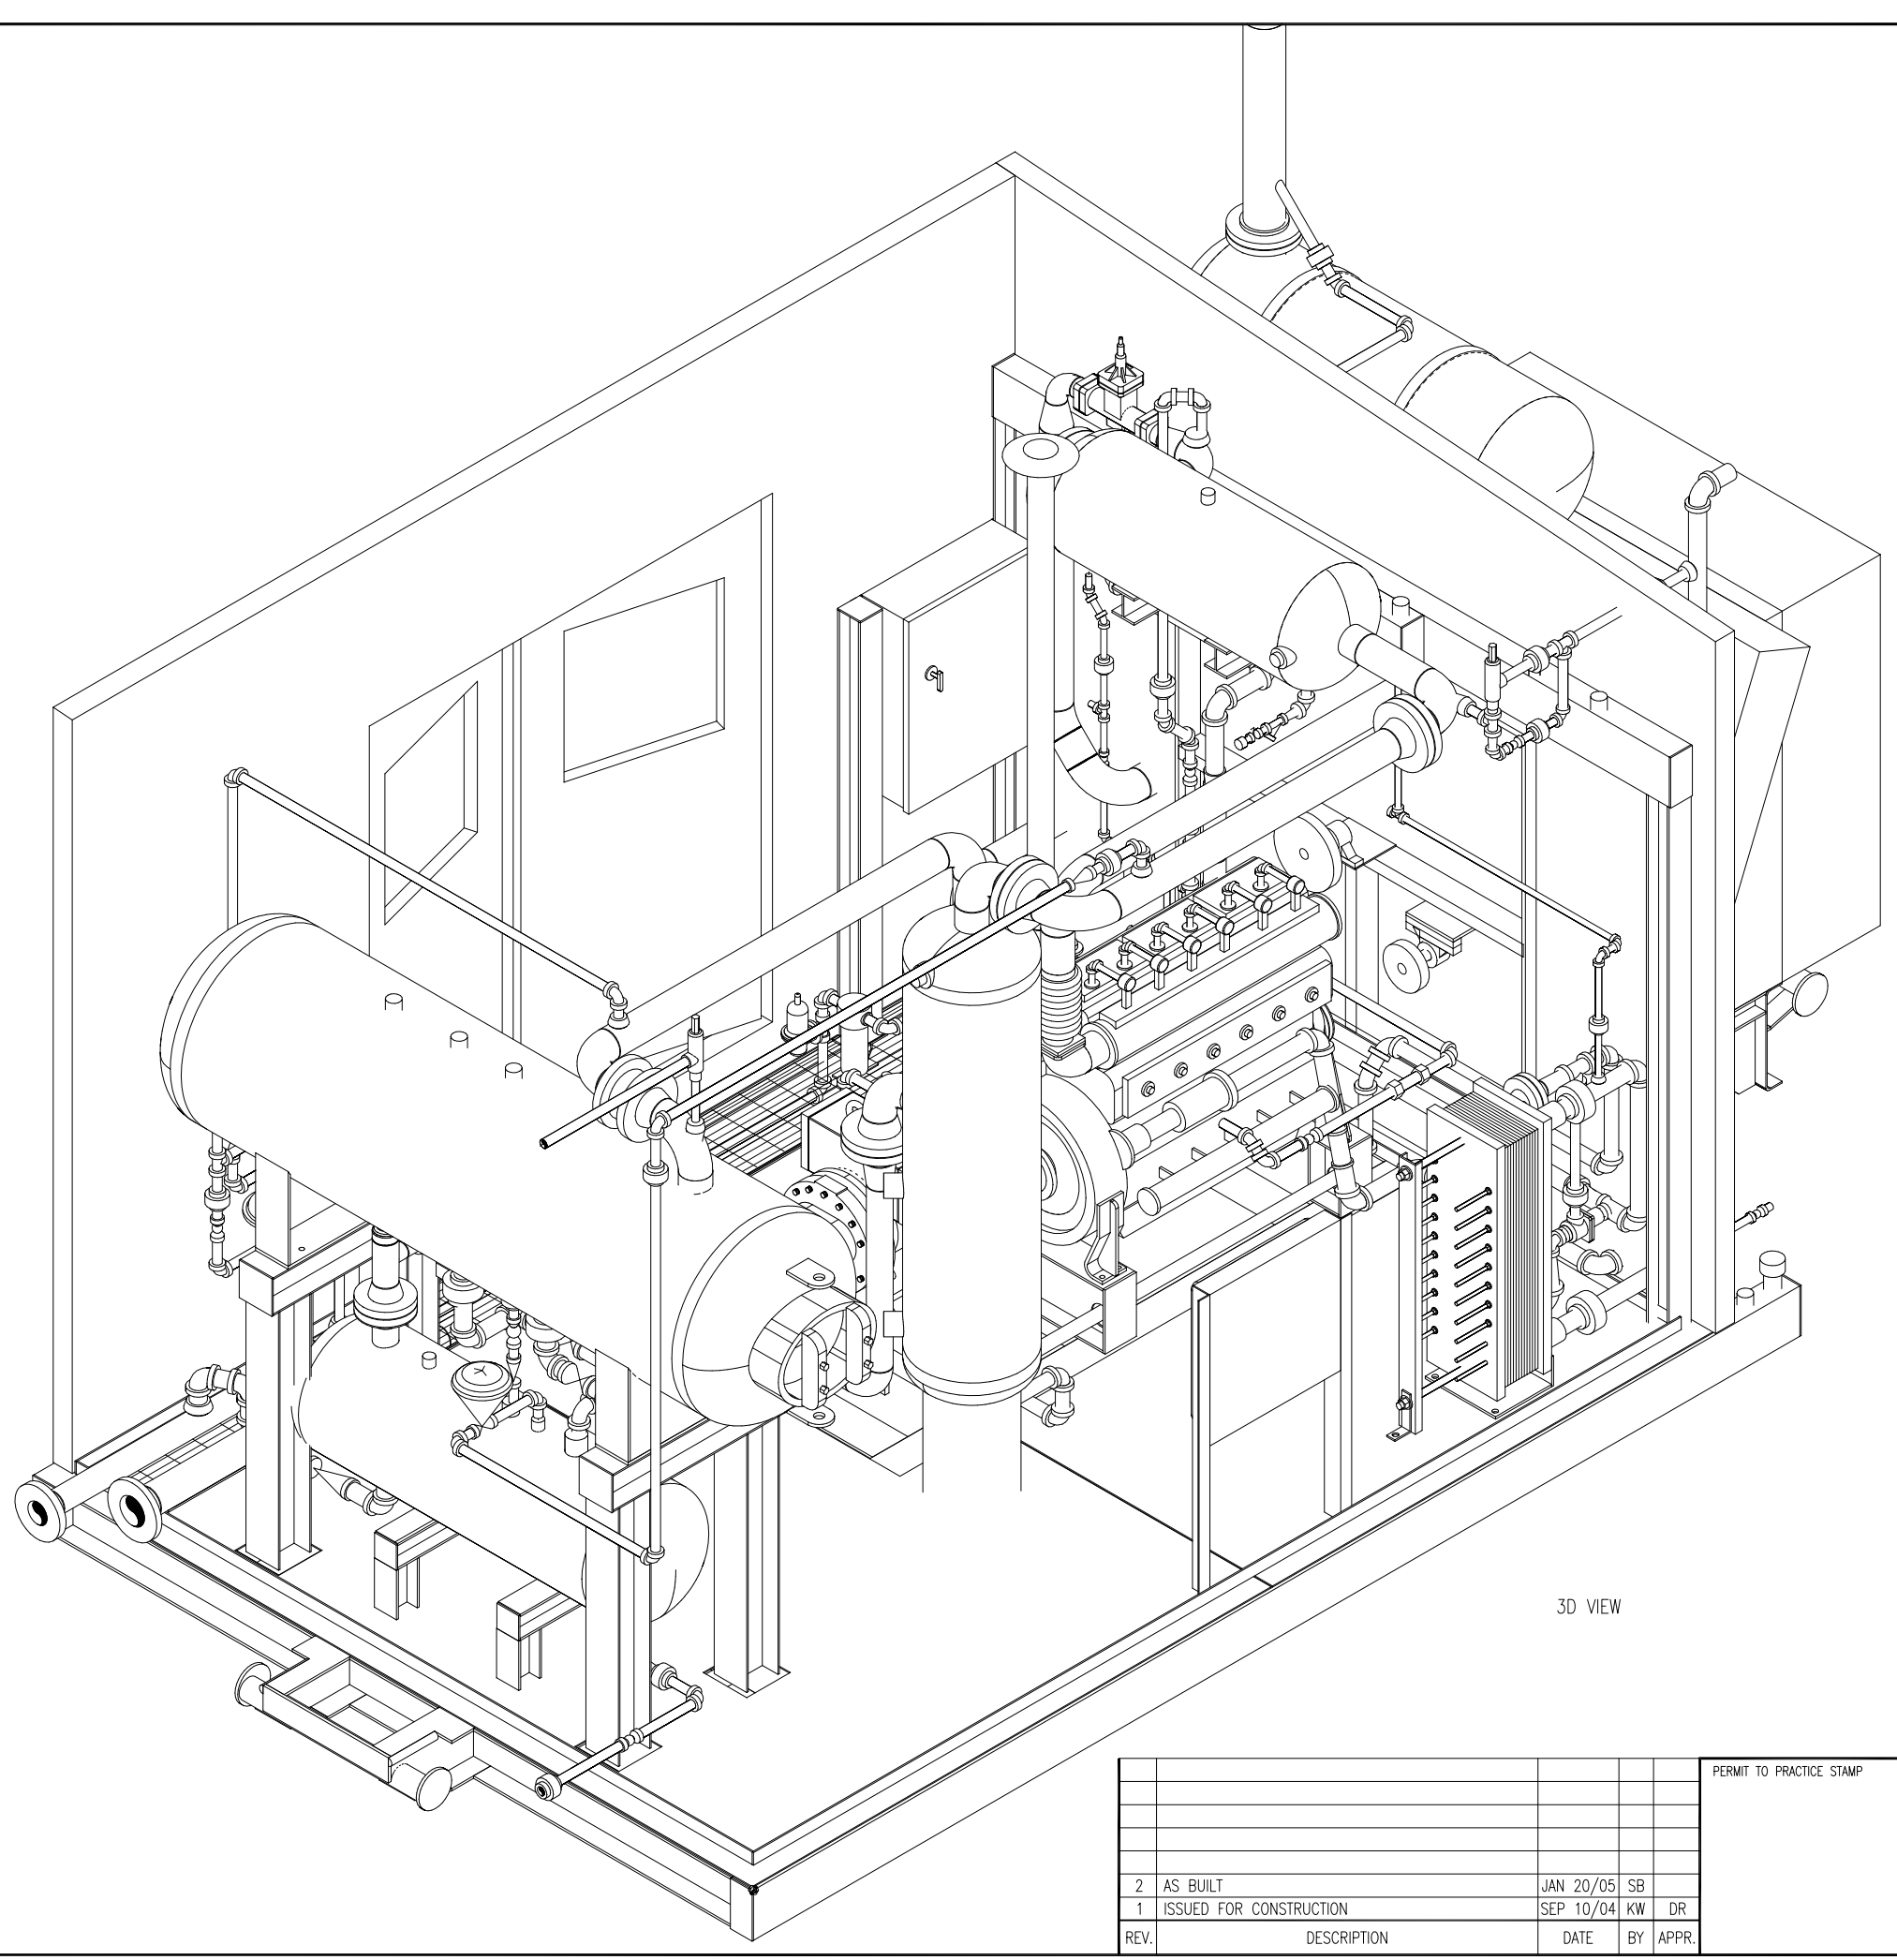

3D VIEW

REV.	DESCRIPTION	DATE	BY	APPR.
2	AS BUILT	JAN 20/05	SB	
1	ISSUED FOR CONSTRUCTION	SEP 10/04	KW	DR

PERMIT TO PRACTICE STAMP

ENGINEER STAMP

TOROMONT | TOROMONT PROCESS SYSTEMS

DRAWN BY: GORD HOWE	DATE: SEP 10, 2004
CHKD. BY: D. ROUSSEAU	SCALE: 1"=1'-0"
APPR. BY: D. ROUSSEAU	W.O. No: 11603201
CUST. PO No:	

TITLE: 3D VIEW

FOR: BURLINGTON RESOURCES
135 HP SE
BOOSTER UNIT
FRICK 151N COMPRESSOR

DWG. No: 11603-201 | SHEET No: 3 OF 3 | REV: 2